


NOTE

ALL DIMENSIONS ARE FOR REFERENCE PURPOSES ONLY AND SHALL NOT BE USED FOR CONSTRUCTION OR PLACEMENT OF EQUIPMENT. ALL SUCH DIMENSIONING SHALL BE THE RESPONSIBILITY OF THE USER OF THESE DOCUMENTS

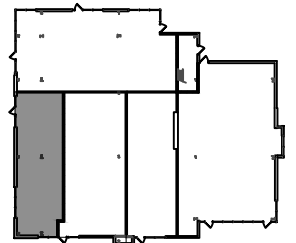

KEY PLAN - 1ST FLOOR

Suite 6553 - 1,133 RSF

07-06-15

SCALE: 1/8" = 1'-0"



Winther-Johnson-Robinson
Architects-Designers

8175-B Lewis Road
Golden Valley, Minnesota 55427

Phone: 763-398-0452 Fax: 763-398-0455

Lyndale Station - Building III

6545-55 Lyndale Avenue South
Richfield, MN 55423



WELLINGTON
MANAGEMENT

Commercial Real Estate

Tel: 651-292-9844 Fax: 651-292-0072