




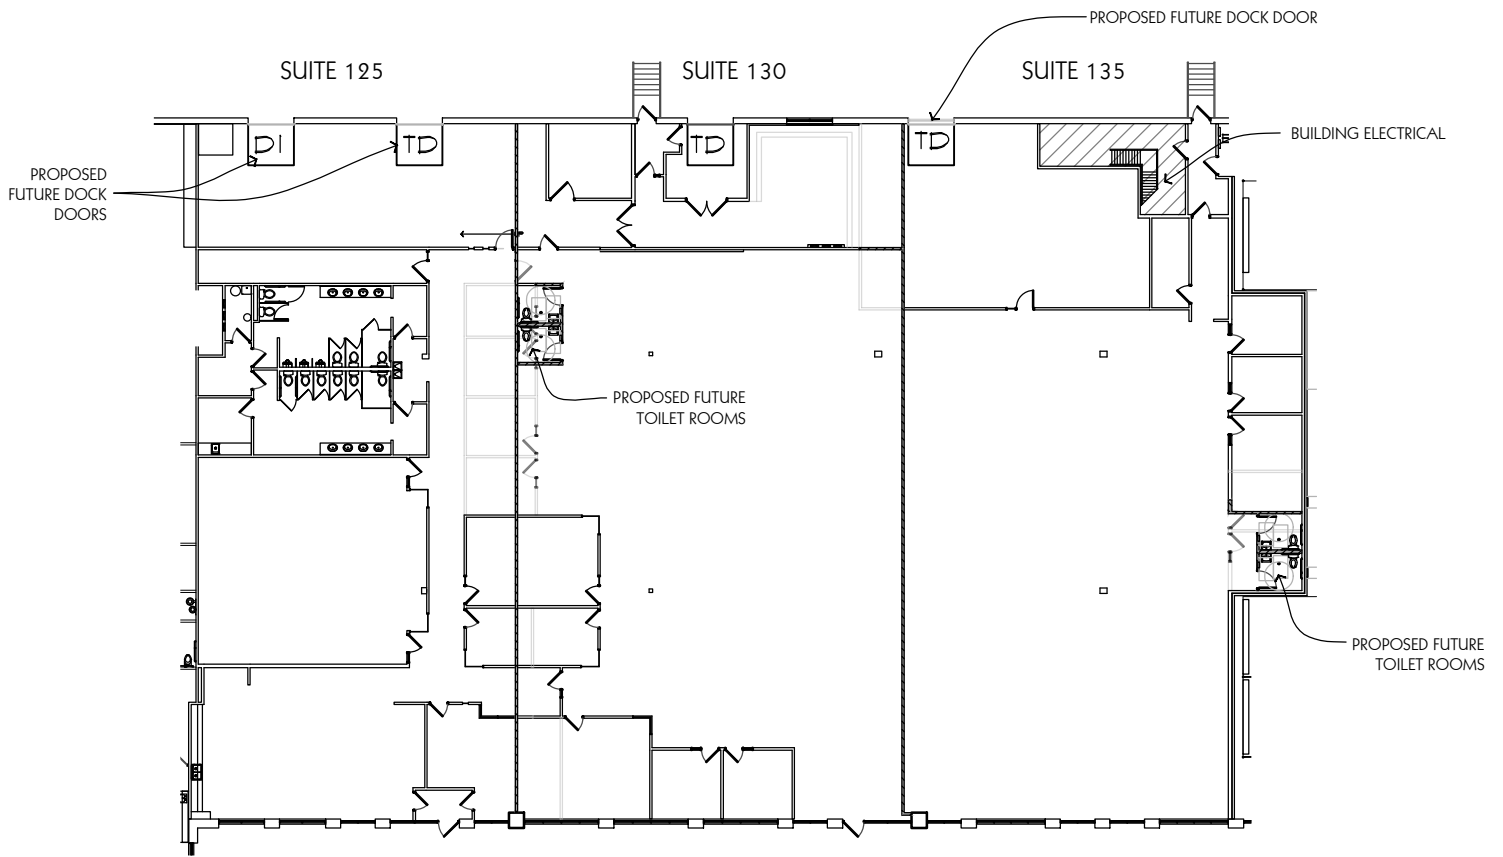

KEY PLAN

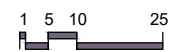

PREPARED BY WJR, INC. April 30, 2026

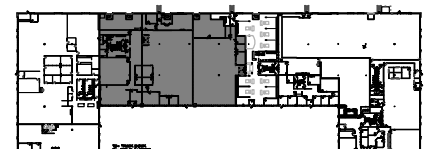

NORTH

Suite 125 - 6,830 RSF

Suite 130 - 8,406 RSF

Suite 135 - 7,430 RSF



Winther-Johnson-Robinson
Architects-Designers

5270 West 84th St., Suite 260
Bloomington, Minnesota 55437
Phone: 763-398-0452

Eagandale Crossing


1020 Discovery Road
Eagan, MN 55121



WELLINGTON
MANAGEMENT


Tel: 651-292-9844 Fax: 651-292-0072

DRAWING FILE NAME: C:\Users\Reed_Robinson\OneDrive\Projects\Egandale Crossing - As-Built
06-22-26.dwg
PLOT DATE: 8/26/2026 11:16 AM

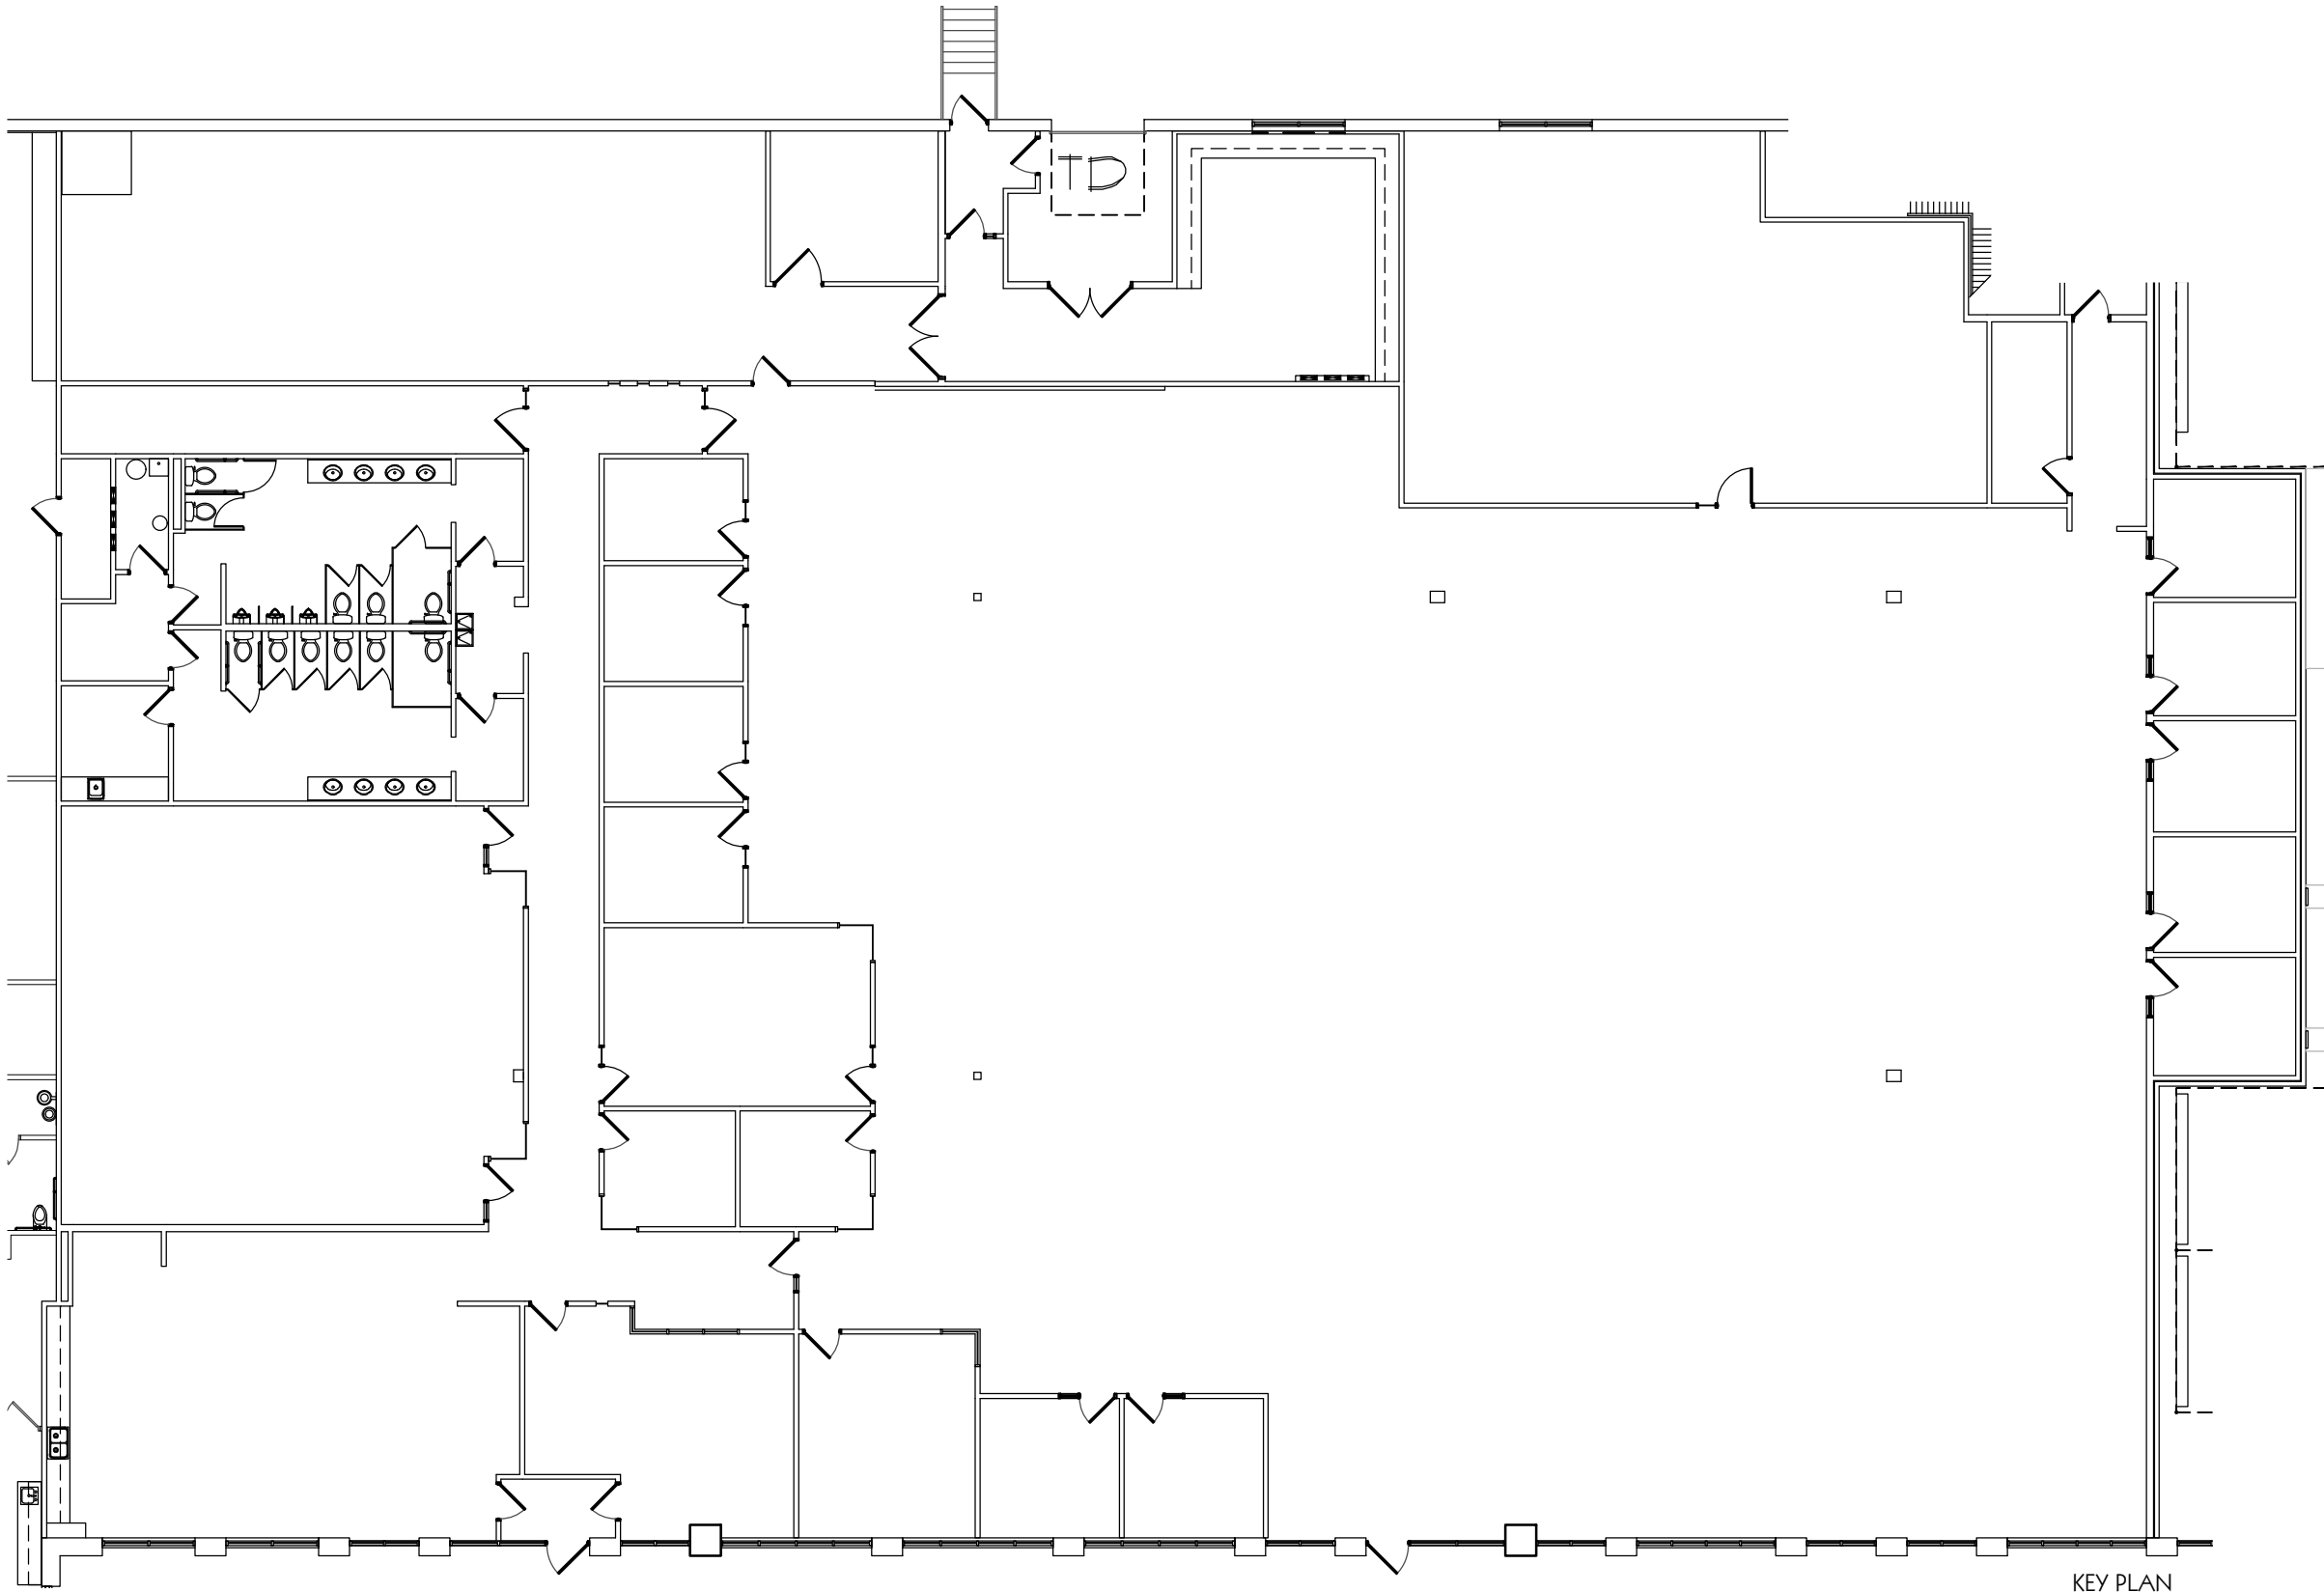

1
A1
SUITE 130 - AS-BUILT
22,796 RSF
SCALE: 1/16" = 1'-0"

KEY PLAN

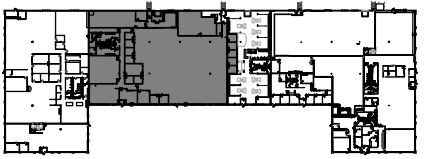

Egandale Crossing - Suite 130 As-built
1020 Discovery Road
Eagan, MN 55121

Issues & Revisions:
Origination Date:
08-26-26
Project No.:
26-364.03A
Scale:
As Noted
Drawn By: RFR
Approval: