


KEY PLAN - 1ST FLOOR

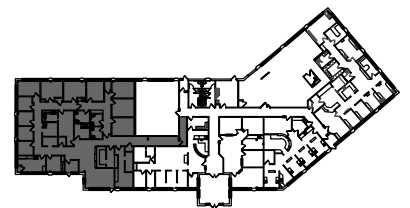

# Suite 160 - 5,711 RSF

06-05-24



PREPARED BY WJR, INC.

June 5, 2024

NORTH



Winther-Johnson-Robinson  
Architects-Designers  
8175-B Lewis Road  
Golden Valley, Minnesota 55427  
Phone: 763-398-0452

## Valley Creek Commons

8380 City Centre Drive  
Woodbury, MN 55125



**WELLINGTON**  
MANAGEMENT

Commercial Real Estate

Tel: 651-292-9844 Fax: 651-292-0072